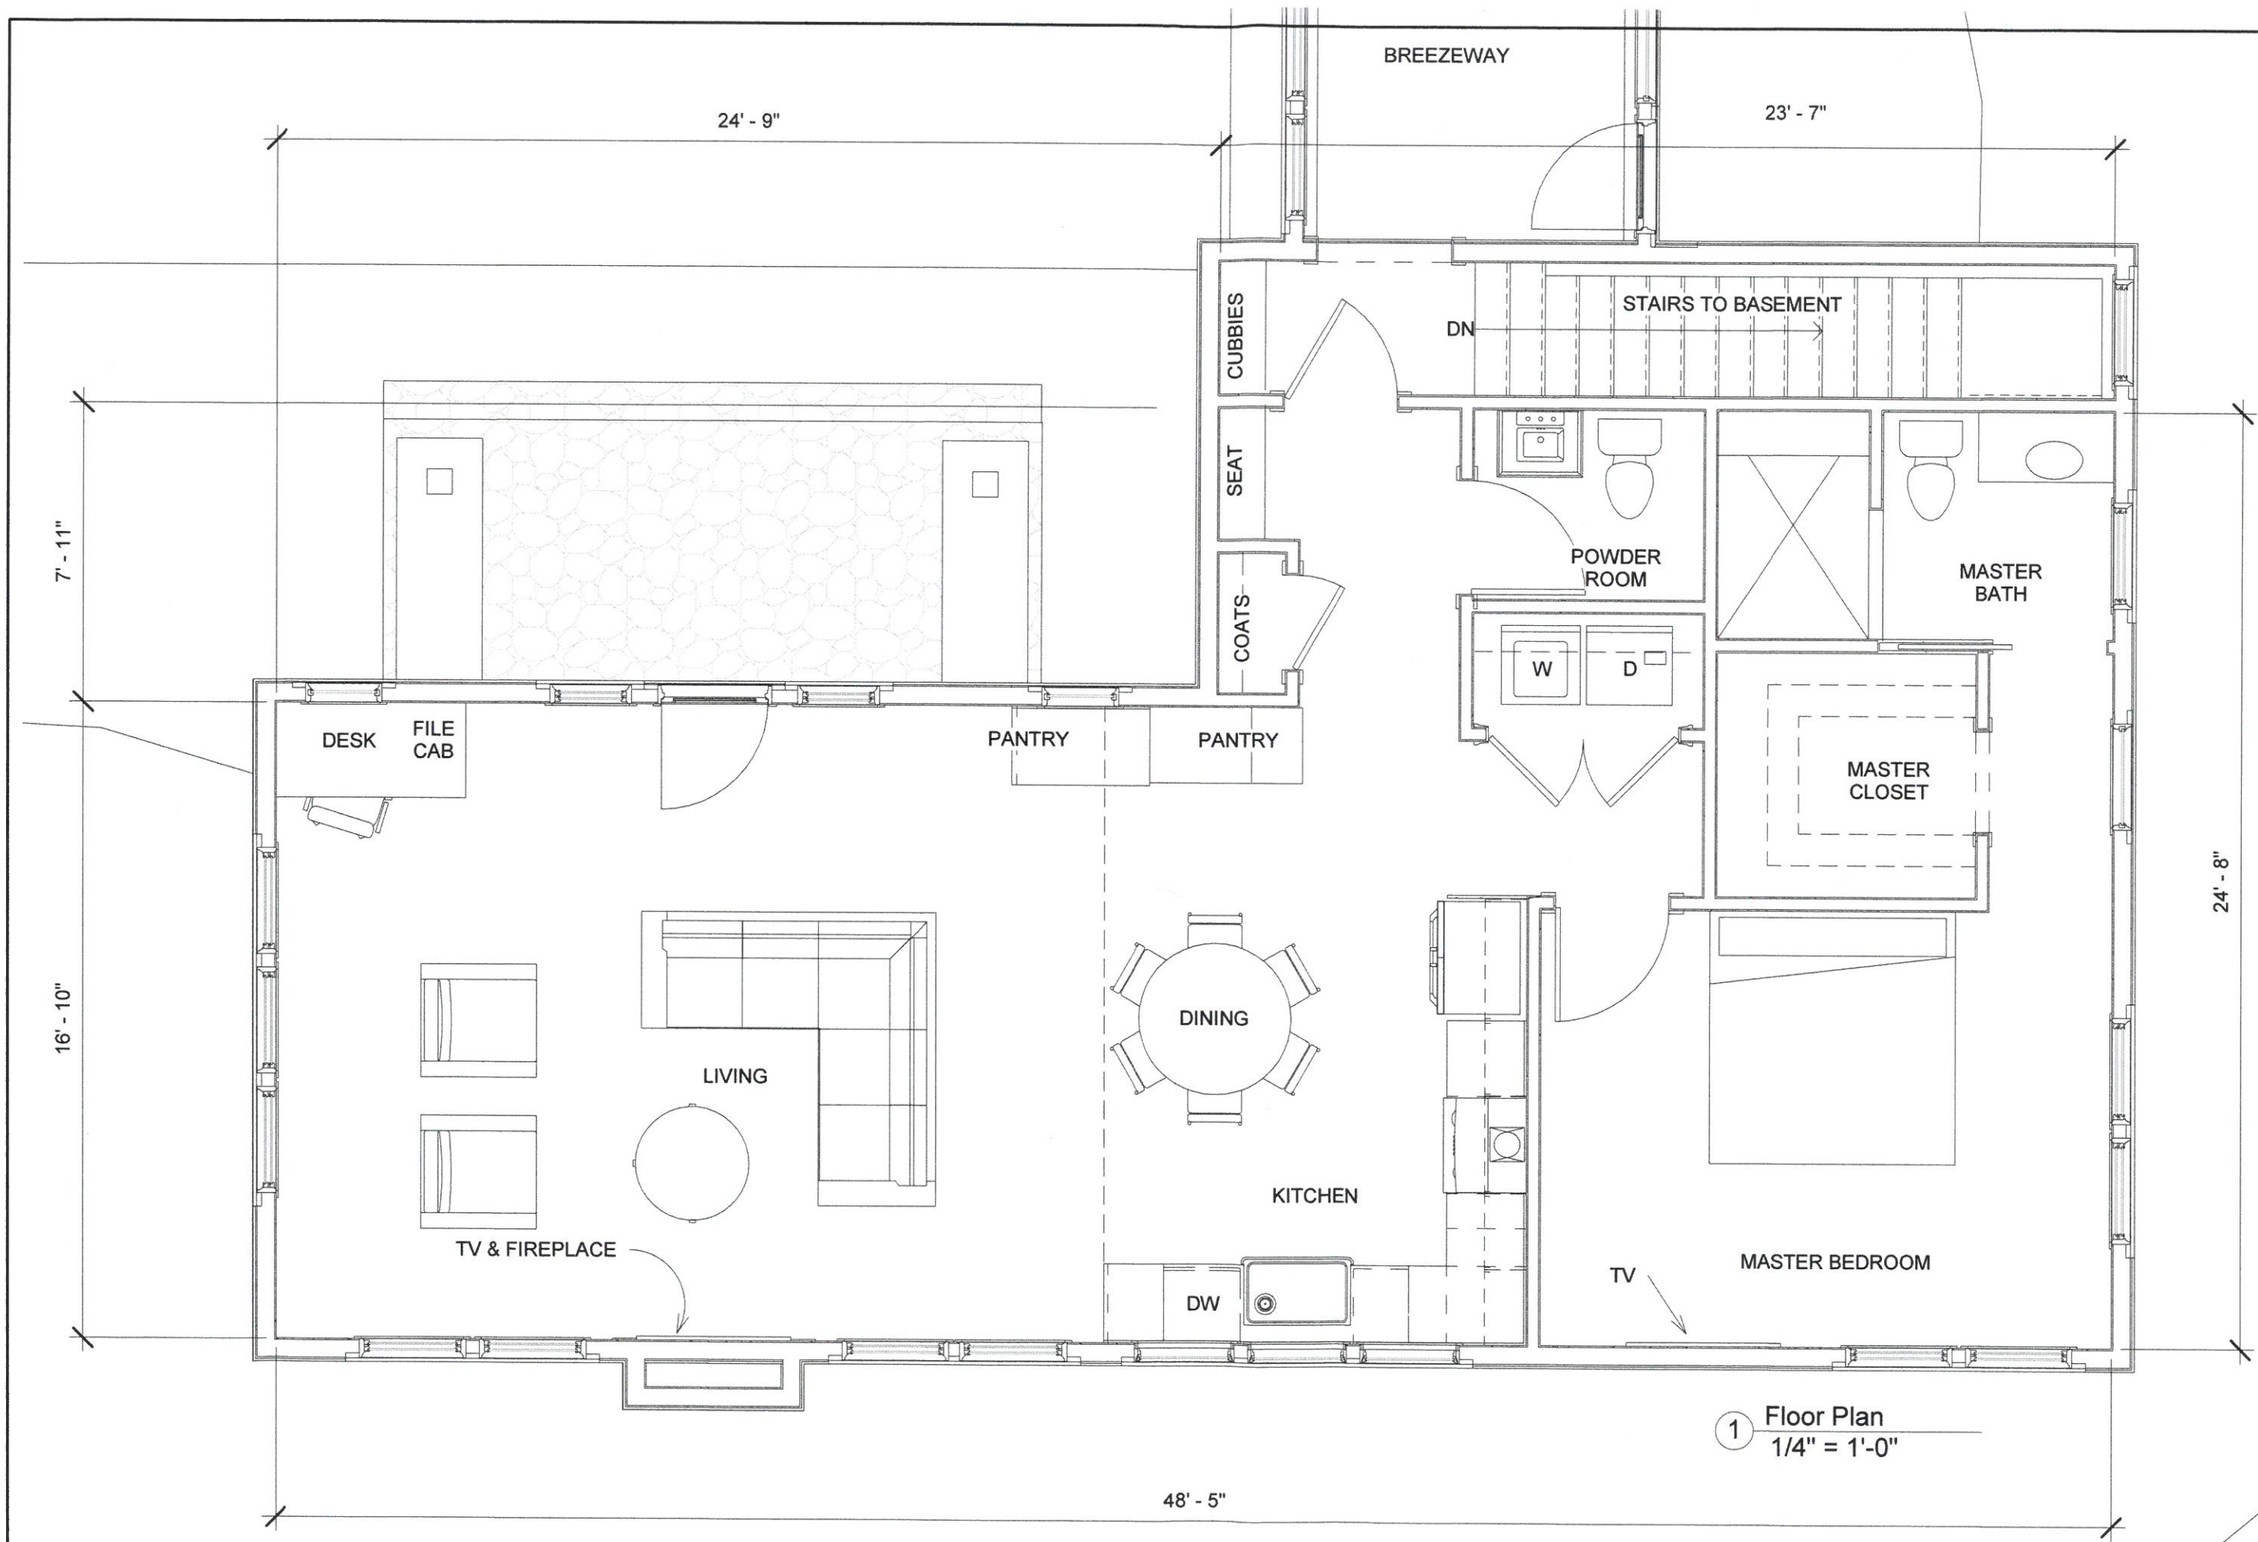


1 Floor Plan
1/4" = 1'-0"


11 MARCH 2020

Bee Howes
ARCHITECT
781-444-1855
beehowes-arch.com
www.hrowes-arch.com
Needham, MA 02492

Nagle Eknaian
Carriage House
385 Green Street
Boylston, Massachusetts

Floor Plan

SK-1

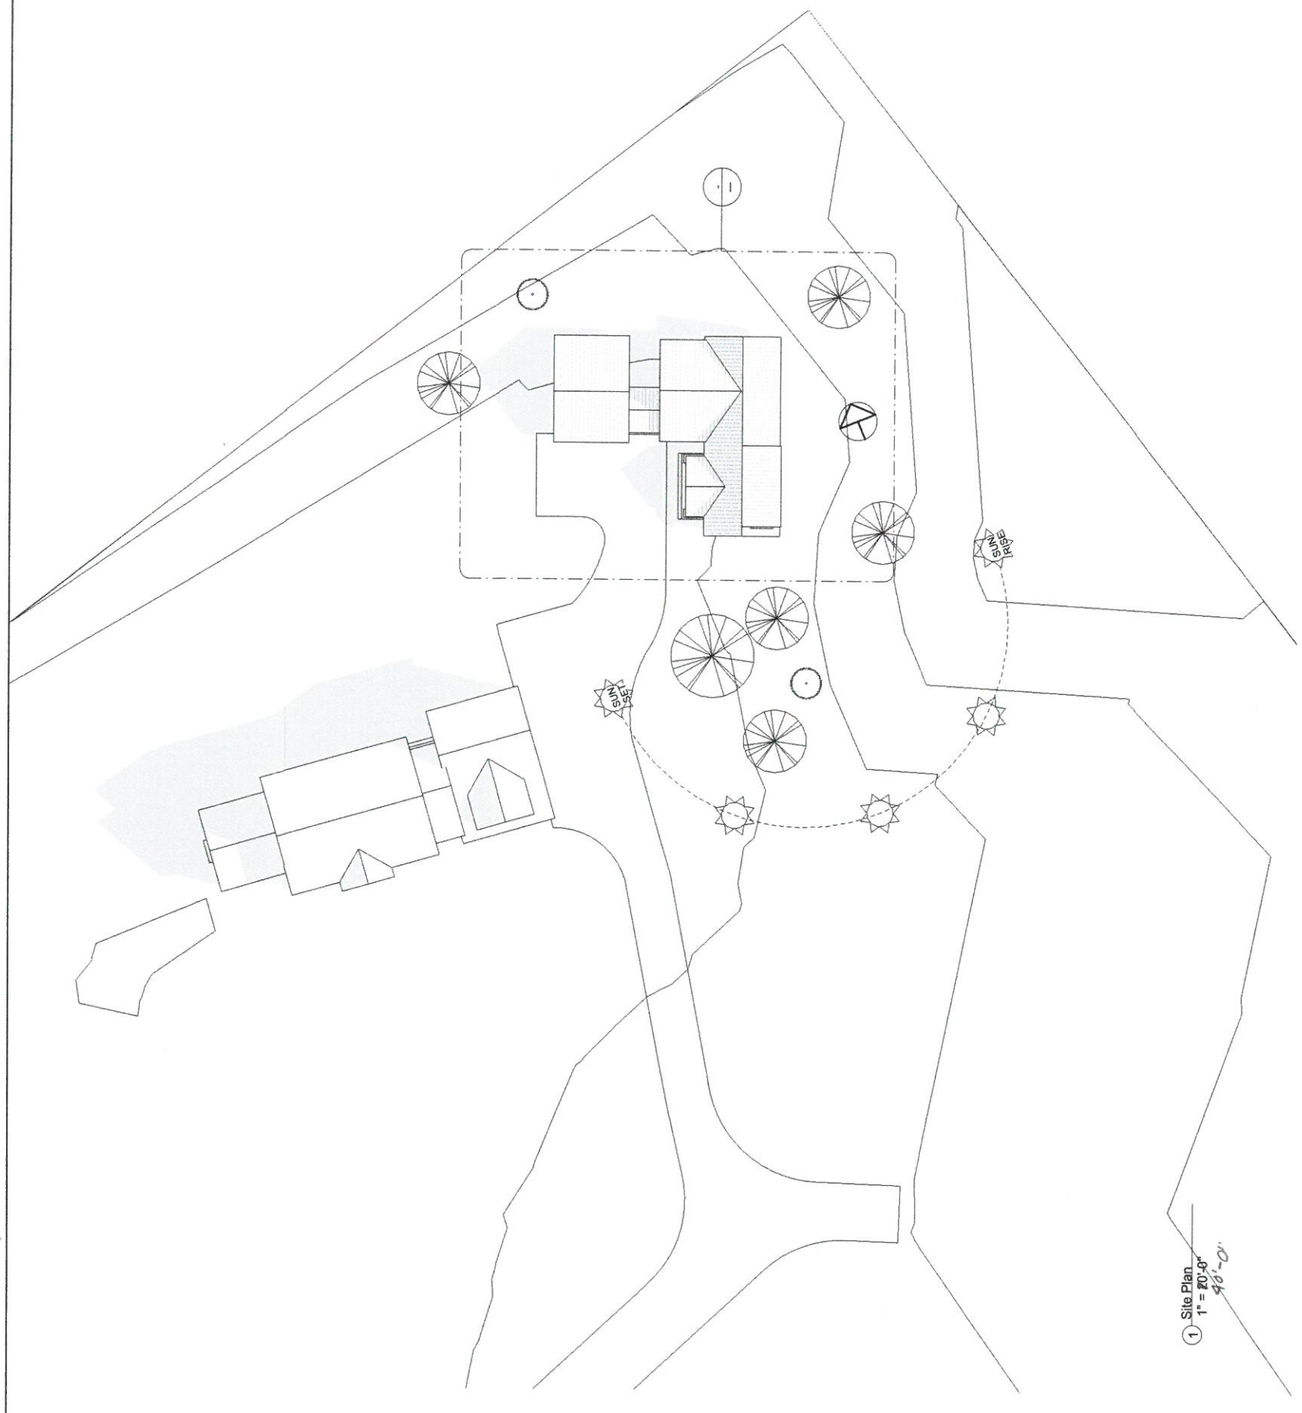

1 Site Plan
1" = 20'-0"
40'-0"

List of Drawings

Sheet Number	Sheet Name
A1.0	Site Plan / Title Page
A1.1	First Floor Plan
A1.2	Basement & Roof Plans
A2.1	Elevations
A2.2	Elevations
SK-2	Views
SK-3	Views
SK-4	Views
SK-5	Kitchen Plan
SK-6	Unnamed



2 view of approach



3 South East

11 MARCH 2020


Bee Howes
ARCHITECT
781-444-1855
bee@howes-arch.com
www.howes-arch.com
Needham, MA 02492

Nagle Eknaian
Carriage House
385 Green Street
Boylston, Massachusetts

Site Plan / Title Page

ISSUED		
	Approver	ISSUED FOR
1		
2		
3		
4		
5		
6		

A1.0

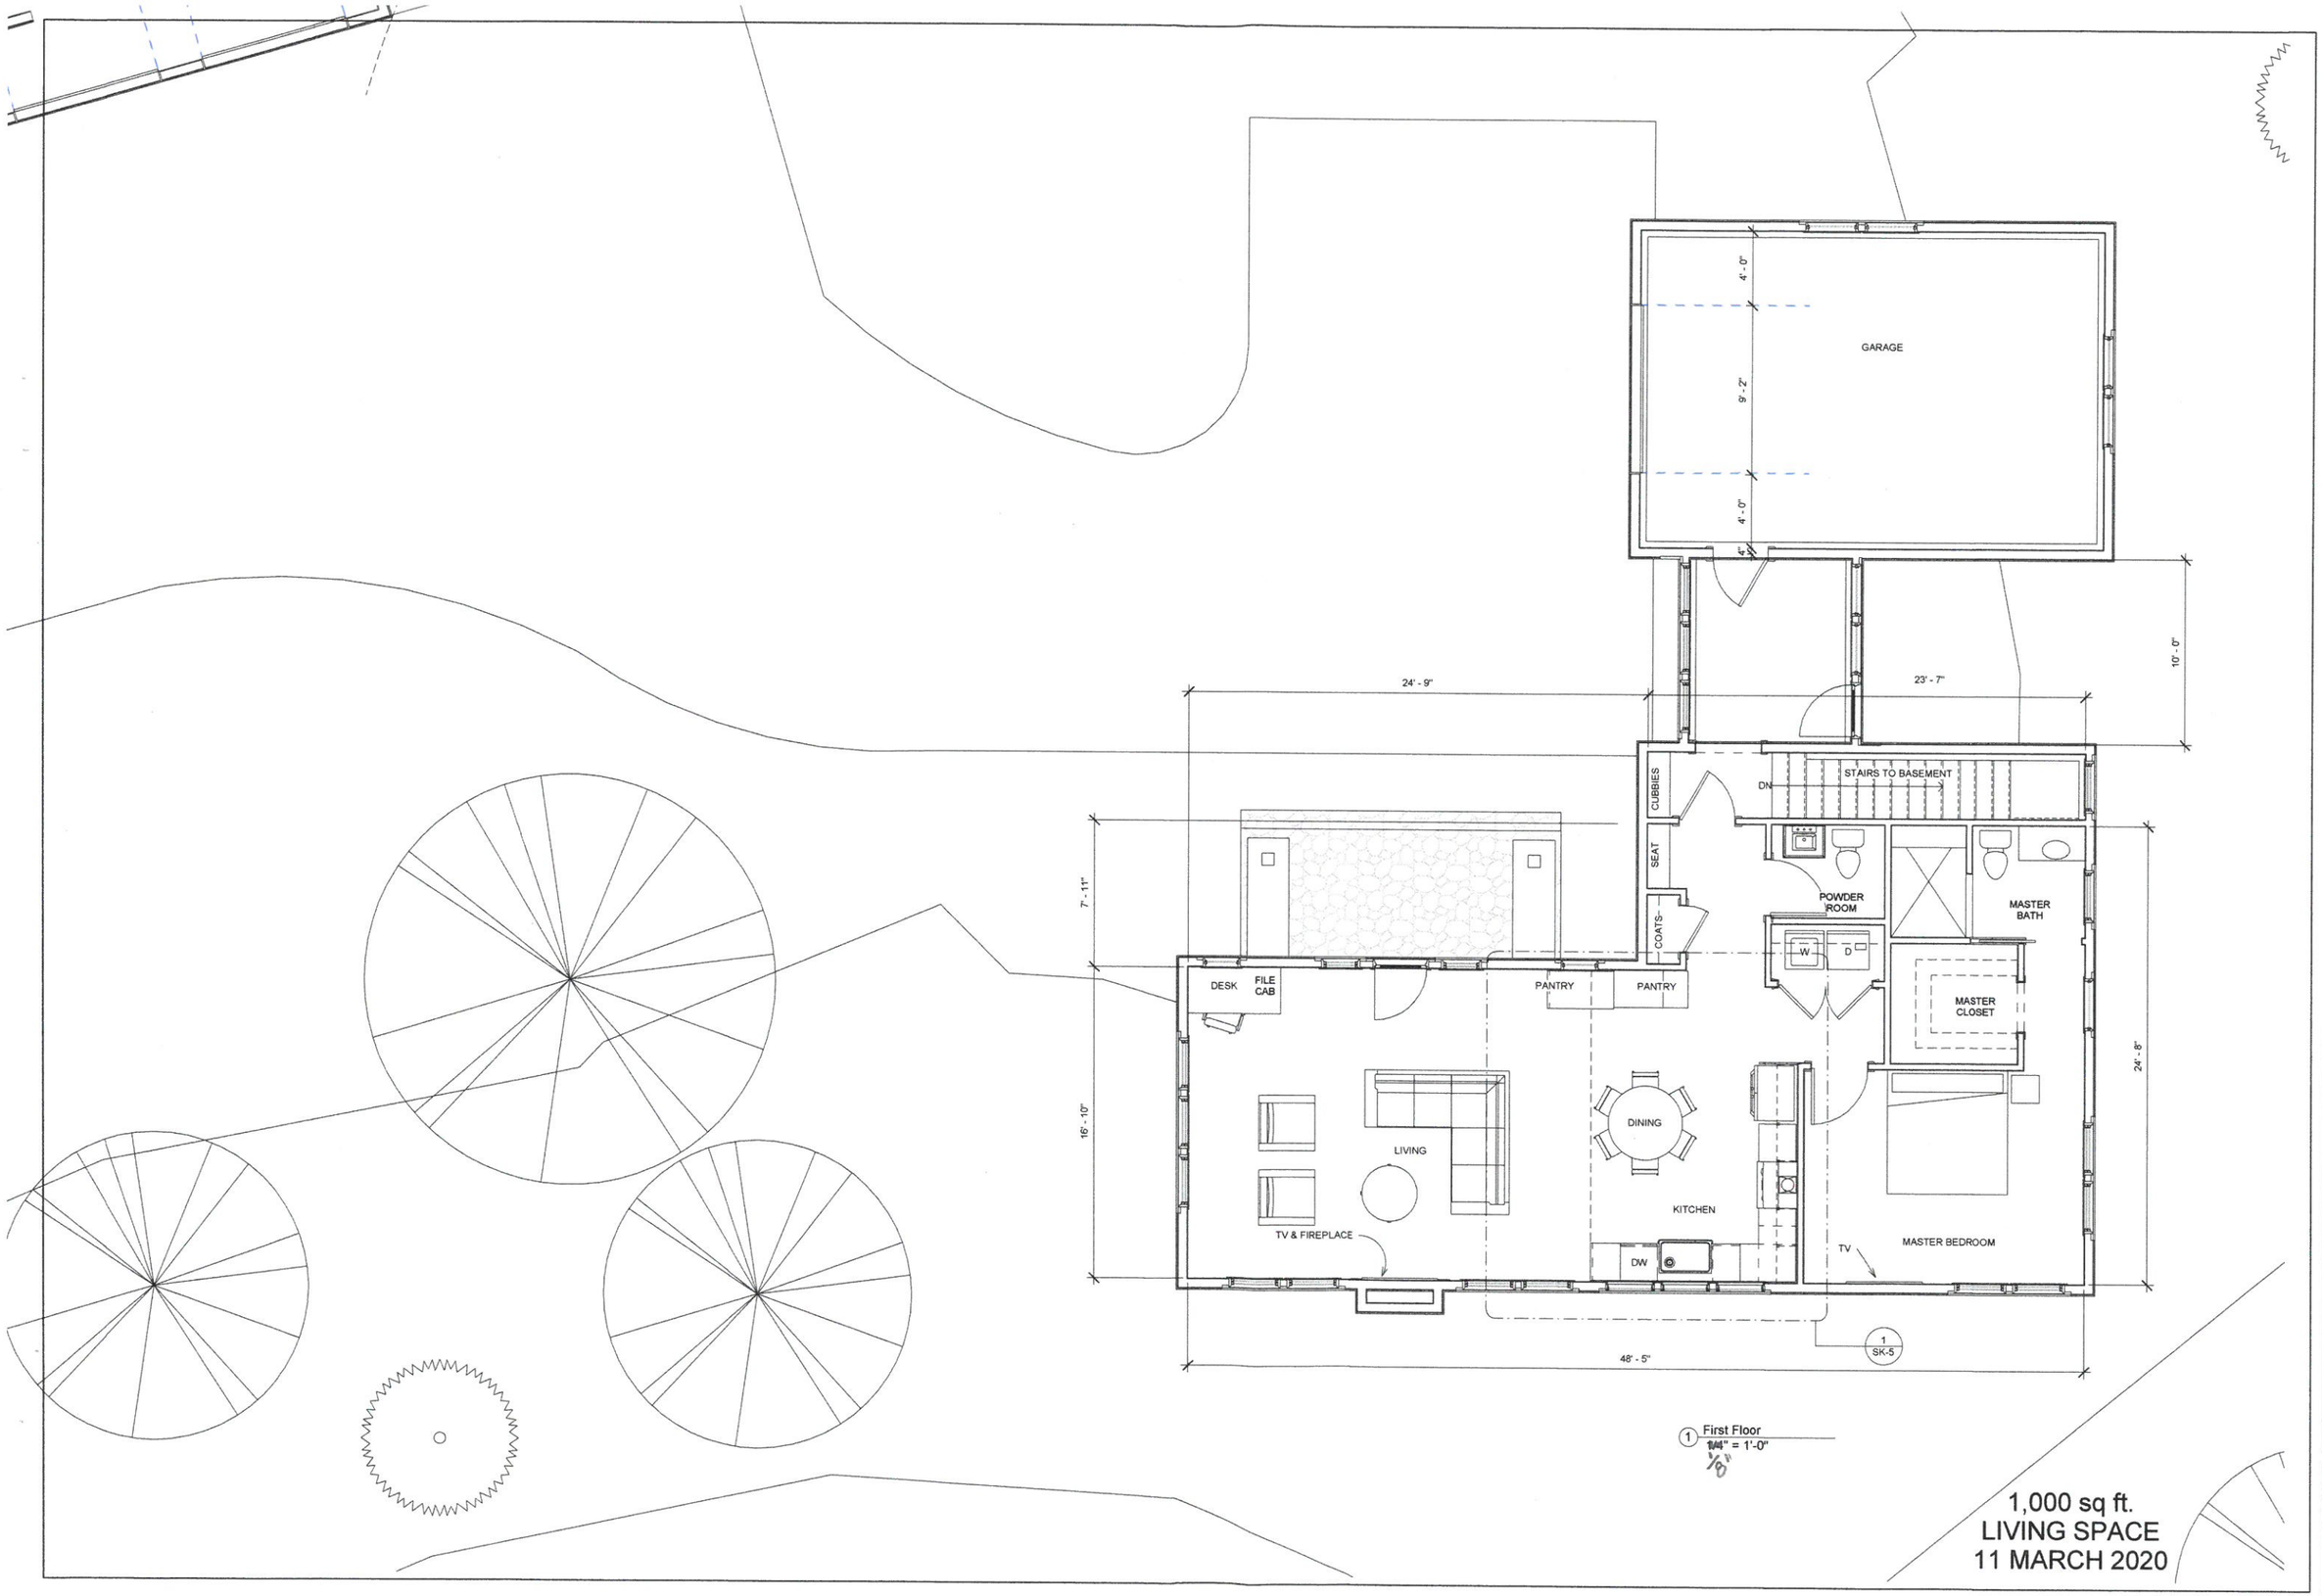

1 First Floor
1/4" = 1'-0"
1/8"

1,000 sq ft.
LIVING SPACE
11 MARCH 2020

Bee Howes
ARCHITECT
781-444-1855
bee@howes-arch.com
www.howes-arch.com
60 Oakcrest Road
Needham, MA 02492


Nagle Eknaian Carriage House

385 Green Street
Boylston, Massachusetts


First Floor Plan

ISSUED	Approver	ISSUED FOR
1		
2		
3		
4		
5		
6		

A1.1

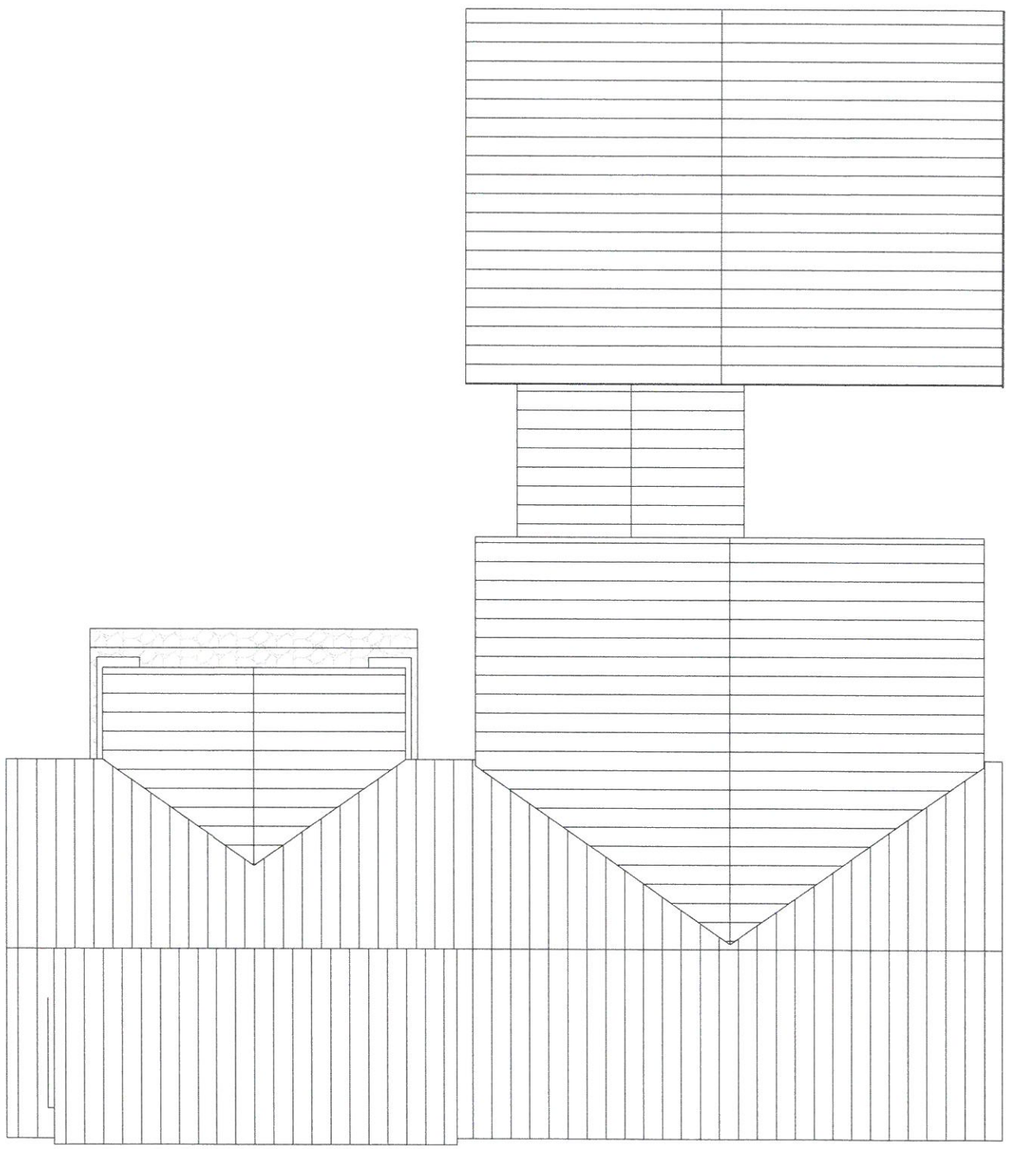

2 Roof Plan
~~1/4" = 1'-0"~~ 1/8"

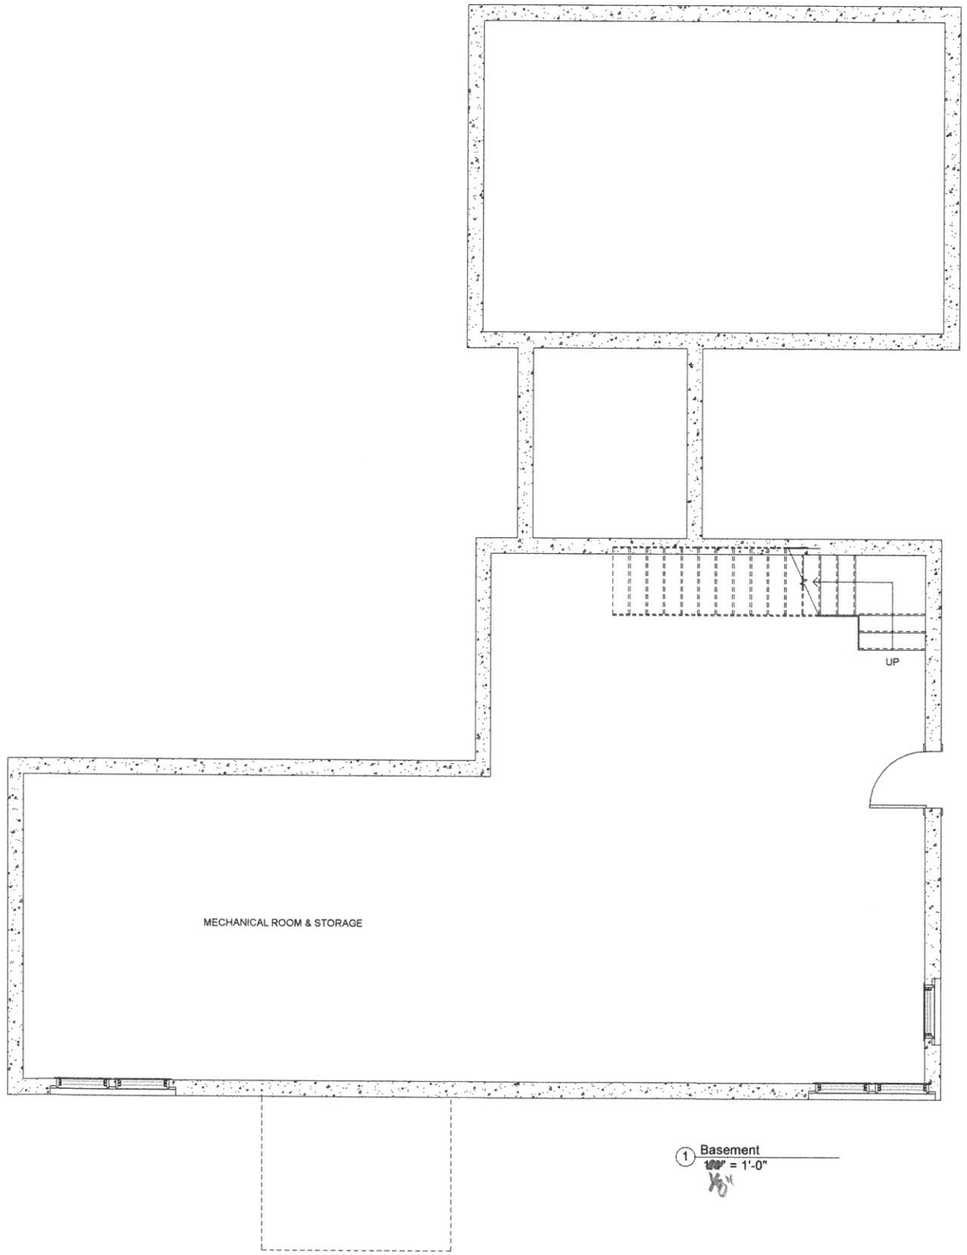

1 Basement
~~1/4" = 1'-0"~~ 1/8"

11 MARCH 2020

Bee Howes
ARCHITECT
781-444-1855
bee@howes-arch.com
www.howes-arch.com
60 Oakcrest Road
Needham, MA 02492

Nagle Eknaian
Carriage House
385 Green Street
Boylston, Massachusetts

Basement & Roof Plans

ISSUED	Approver	ISSUED FOR
1		
2		
3		
4		
5		
6		

A1.2



1 1 South Elevation - Approach
1/4" = 1'-0"
1/8"

2 2 East Elevation - Wood View
1/4" = 1'-0"
1/8"

11 MARCH 2020

Bee Howes
ARCHITECT
781-444-1855
60 Oakcrest Road,
Needham, MA 02492

Nagle Eknaian
Carriage House
385 Green Street
Boylston, Massachusetts

Elevations

ISSUED	Approver	ISSUED FOR
1		
2		
3		
4		
5		
6		

A2.1



1 3 West Elevation - Facing the Main House
1/4" = 1'-0"



2 4 North Elevation - Rear
1/4" = 1'-0"

11 MARCH 2020

Bee Howes
ARCHITECT
781-444-1855
bee@howes-arch.com
www.howes-arch.com

Nagle Eknaian
Carriage House
385 Green Street
Boylston, Massachusetts

Elevations

ISSUED	Approver	ISSUED FOR
1		
2		
3		
4		
5		
6		

A2.2